



Control panel 1 x 1.5kW DOL
3 x 380V 60Hz

Number of Pumps	:	1
Rated Power	:	1.5kW
Rated Current	:	3A
Supply rating	:	3 x380V 60Hz
Duty/Assist/Standby	:	1D
Starting Method	:	DOL
IP rating	:	IP54
Ambient Temp.	:	40 deg C
Article Number	:	
Project Name	:	


Additional Specification:

Control panel 1 x 1.5kW 3PH 400V 50Hz		Nabil	 Wilo Middle East FZE Jebel Ali Free Zone–South PO Box 262720 Dubai UAE Tel: (+971 4) 880 91 77 Fax: (+971 4) 880 91 88. Ext. 122			
		CHECKED BY				
		Siva				
TITLE	PROJECT					
		DRAWN				
		6/28/2021				
CONSULTANT	CLIENT	DATE	SCALE	DRAWING NO	REV	PAGE


TECHNICAL DATA SHEET

ENCLOSURE SCHNEIDER ☐ ALFANAR ☐ LOCAL ☒ GRP ☐ MATERIAL SHEET STEEL ☒ STAINLESS STEEL ☐ ALUMINUM ☐ GRP ☐ PRESENTATION FIXED FRONT ☐ FUNCTIONAL DOOR ☒ PLAIN DOOR ☐ TRANSPARENT DOOR ☐ OTHER ☐ TYPE OF CONSTRUCTION FORM - 1 ☒ FORM - 3 ☐ FORM - 4 ☐ DIMENSION (in mm) COLOUR RAL 7032 ☐ RAL 7035 ☒ MOUNTING WALL ☒ FLOOR ☐ PEDESTAL ☐ INSTALLATION INDOOR APPLICATION ☒ OUTDOOR APPLICATION ☐	NEUTRAL/EARTH SYSTEM: DIRECT TO EARTH (TT) ☐ SEPARATE (TN-S) ☒ EARTHED (TN-C) ☐ ISOLATED (IT) ☐ BUS BARS HARD DRAWN HIGH CONDUCTIVITY COPPER ELECTROLYTICALLY TINNED BUSBARS SUITABLY SIZED ☐ MAIN(VER.) Size(XXXX) ☐ MAIN(HOR.) Size(XXXX) ☐ NEUTRAL Size(XXXX) ☐ EARTH Size(XXXX) ☐ BRANCH Size(XXXX) ☐ INSULATION VOLTAGE UPTO 600V CONNECTIONS <table border="0"> <tr> <td>TERMINATION</td> <td>INC.</td> <td>OUTG.</td> </tr> <tr> <td>DIRECT TO DEVICE</td> <td>☒</td> <td>☐</td> </tr> <tr> <td>THRU TERMINAL BLOCKS</td> <td>☐</td> <td>☒</td> </tr> </table> ACCESS <table border="0"> <tr> <td>FRONT</td> <td>☒</td> <td>☒</td> </tr> <tr> <td>REAR</td> <td>☐</td> <td>☐</td> </tr> <tr> <td>LEFT SIDE/ RIGHT SIDE</td> <td>☐</td> <td>☐</td> </tr> </table> CABLE ENTRY <table border="0"> <tr> <td>TOP</td> <td>☐</td> <td>☐</td> </tr> <tr> <td>BOTTOM</td> <td>☒</td> <td>☒</td> </tr> </table> SHROUDING <table border="0"> <tr> <td>ALL LIVE PARTS</td> <td>☒</td> <td>☒</td> </tr> </table> WIRING <table border="0"> <tr> <td>CONTROL 1.0 Sqmm</td> <td>☒</td> </tr> <tr> <td>C.T WIRES 2.5Sqmm</td> <td>☐</td> </tr> </table>	TERMINATION	INC.	OUTG.	DIRECT TO DEVICE	☒	☐	THRU TERMINAL BLOCKS	☐	☒	FRONT	☒	☒	REAR	☐	☐	LEFT SIDE/ RIGHT SIDE	☐	☐	TOP	☐	☐	BOTTOM	☒	☒	ALL LIVE PARTS	☒	☒	CONTROL 1.0 Sqmm	☒	C.T WIRES 2.5Sqmm	☐	AUXILIARY SUPPLY VOLTAGE 240V AC ☐ 220V AC ☒ 110V AC ☐ 24V AC ☐ 24V DC ☐ ORIGIN EXTERNAL ☐ INTERNAL ☒ AUXILIARY TRANSFORMER ☐ AUXILIARY DC SOURCE ☐ CIRCUIT MARKING WIRING > Power Cable : Phase : Upto - 16sqmm - Red, yellow, Blue Above 16sqmm - black cable with color code sleeve Neutral : Black Earth : Yellow + Green Control Cable : 230V AC : Red+Black 110V AC : Orange 24VAC : Grey 12V/24V DC : Blue(+), White(-) Volt Free contact : Brown LABELS FACIA LEGEND PLATES OF 1.5mm PRINTED PVC WITH WHITE LETTERS ON BLACK BACKGROUND ALL LABELS WITH CHAMFERED EDGES DANGER LABELS WITH WHITE LETTERS ON RED BACKGROUND	Standard Specification: Motor overload protection Door components: Run, Trip indication HOA switch TYPE OF DRAWING ISSUED FOR APPROVAL ☐ ISSUED FOR PRODUCTION ☐ AS BUILT DRAWING ☒ ALL DIMENSIONS ARE IN mm
TERMINATION	INC.	OUTG.																																
DIRECT TO DEVICE	☒	☐																																
THRU TERMINAL BLOCKS	☐	☒																																
FRONT	☒	☒																																
REAR	☐	☐																																
LEFT SIDE/ RIGHT SIDE	☐	☐																																
TOP	☐	☐																																
BOTTOM	☒	☒																																
ALL LIVE PARTS	☒	☒																																
CONTROL 1.0 Sqmm	☒																																	
C.T WIRES 2.5Sqmm	☐																																	

Control panel 1 x 1.5kW 3PH 400V 50Hz		Nabil CHECKED BY	 Wilo Middle East FZE Jebel Ali Free Zone-South PO Box 262720 Dubai UAE Tel: (+971 4) 880 91 77 Fax: (+971 4) 880 91 88. Ext. 122			
TITLE	PROJECT	Siva	DRAWN	6/28/2021		
CONSULTANT	CLIENT	DATE	SCALE	DRAWING NO	REV	PAGE

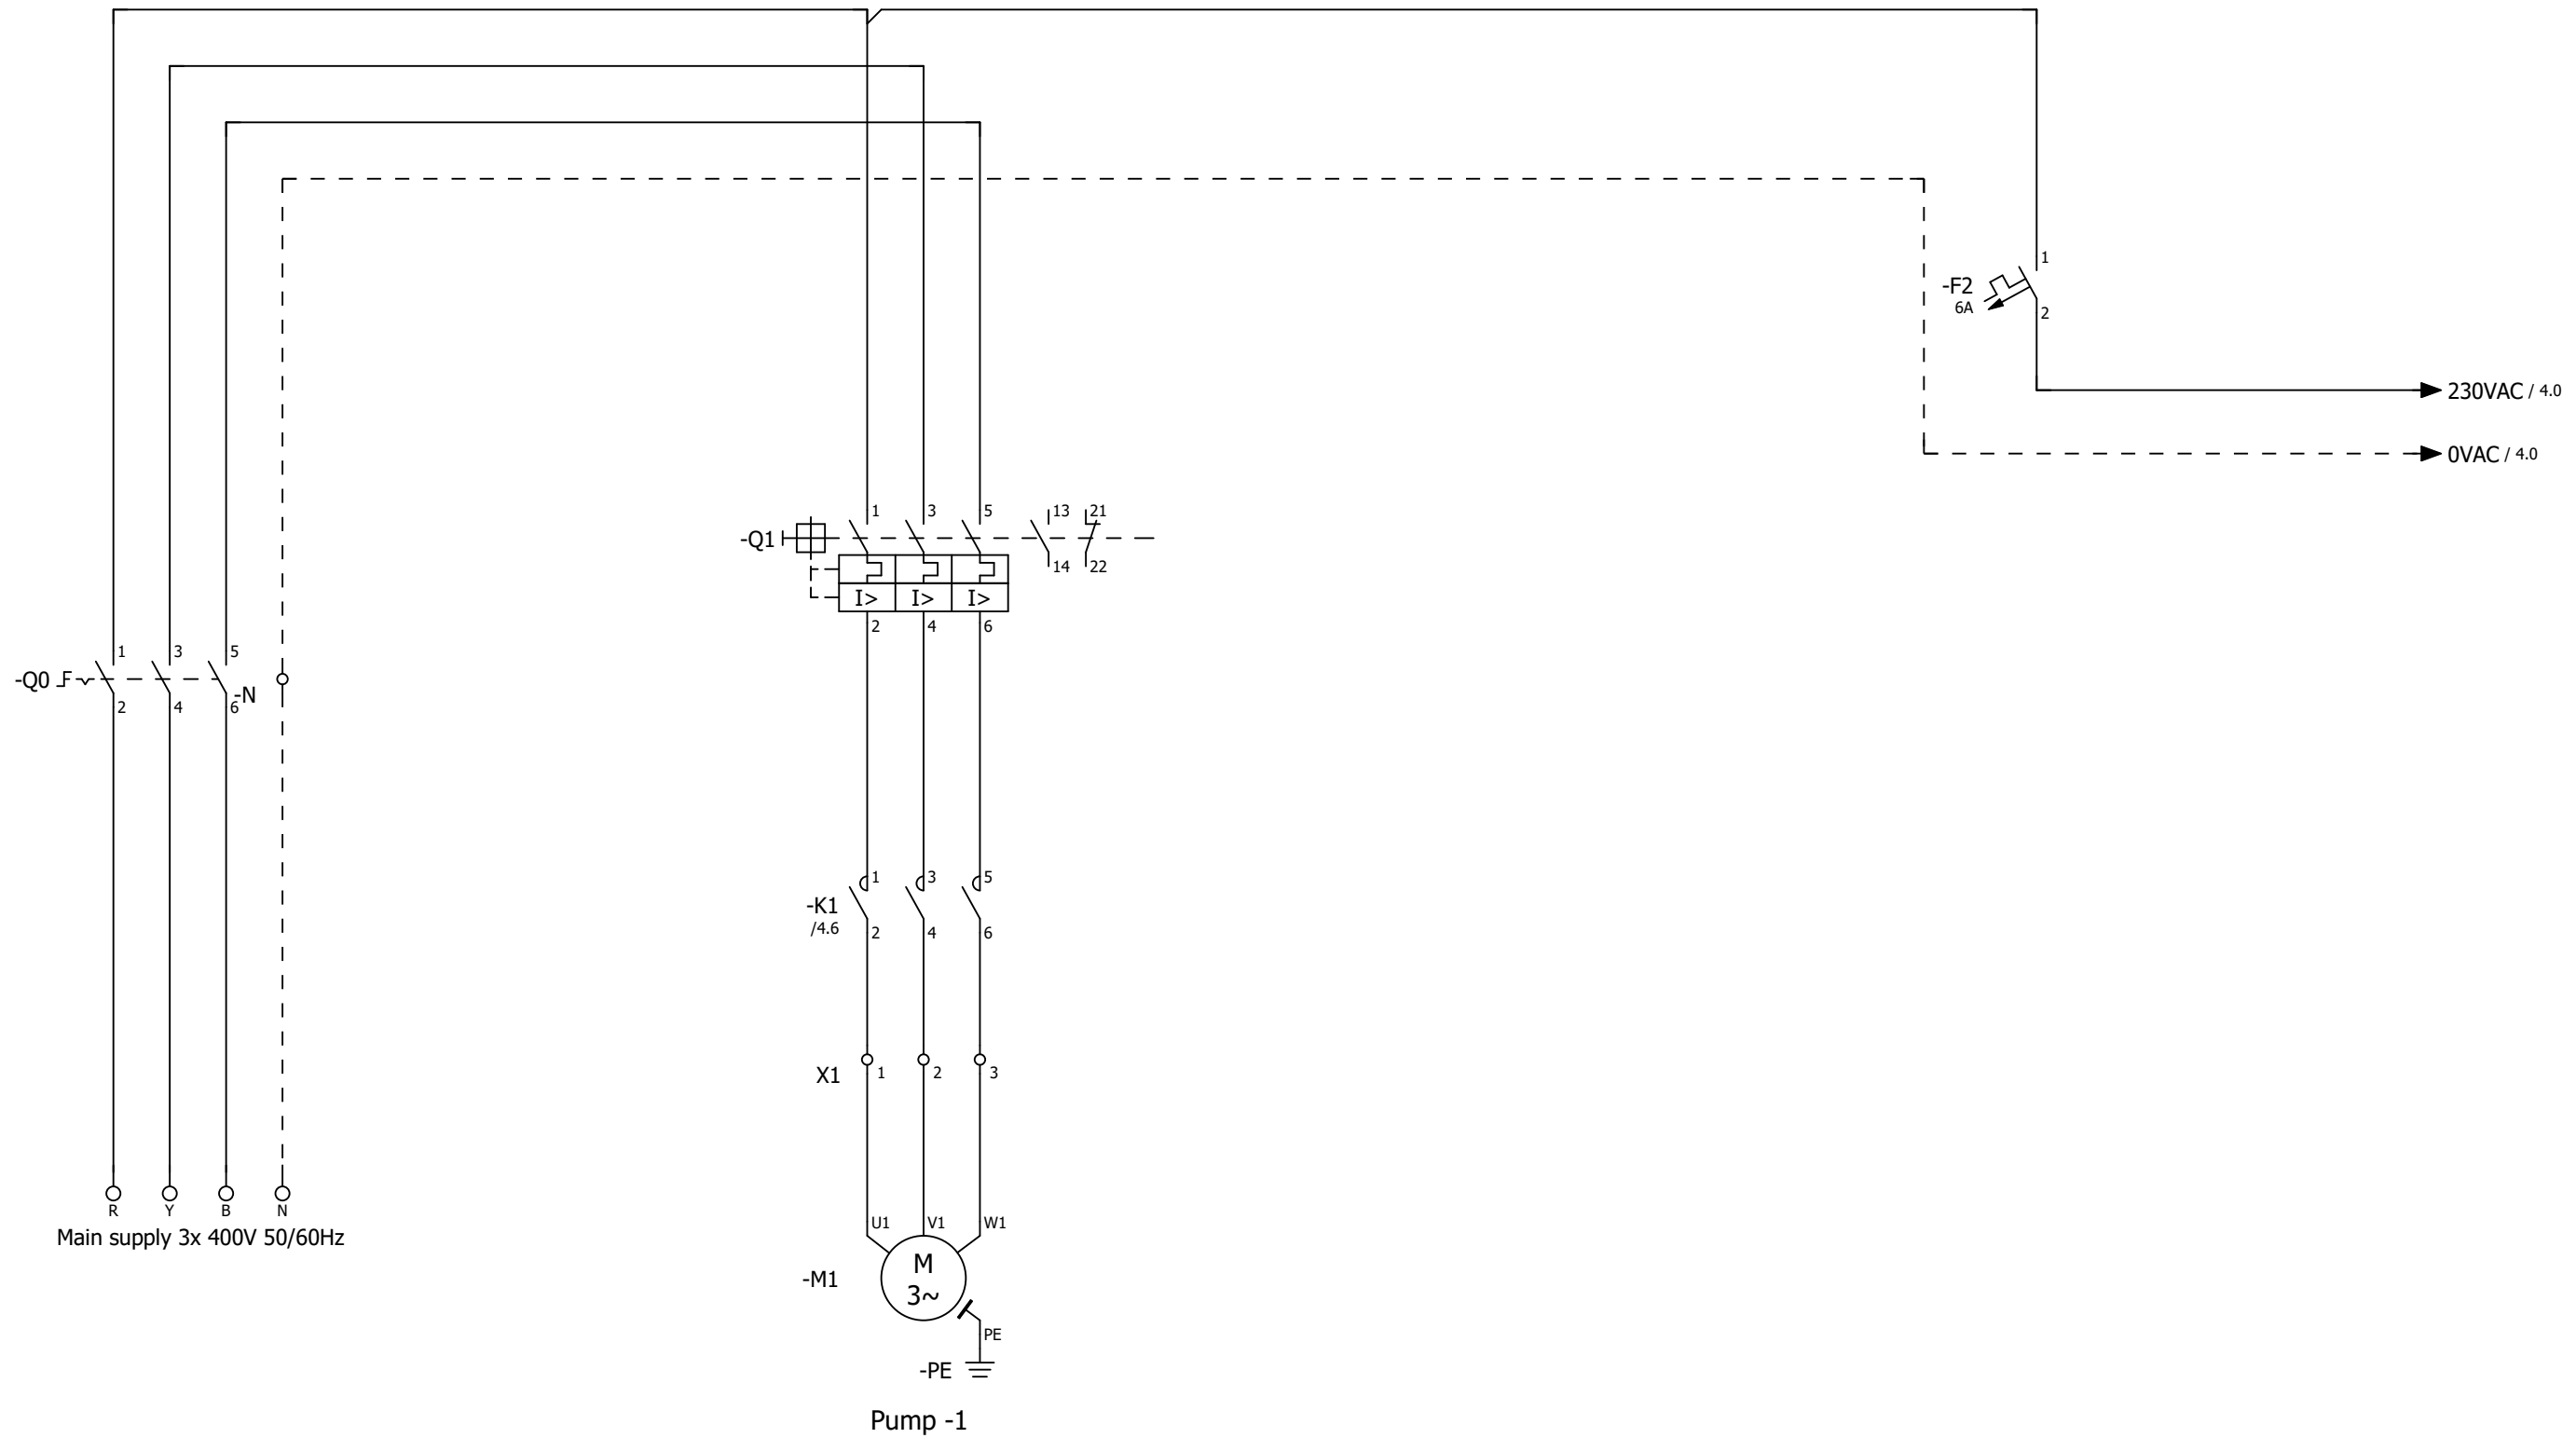


Control panel 1 x 1.5kW 3PH 400V 50Hz		Nabil	 Wilo Middle East FZE Jebel Ali Free Zone-South PO Box 262720 Dubai UAE Tel: (+971 4) 880 91 77 Fax: (+971 4) 880 91 88. Ext. 122			
		CHECKED BY				
TITLE	PROJECT	Siva				
		DRAWN				
		6/28/2021				
CONSULTANT	CLIENT	DATE	SCALE	DRAWING NO	REV	PAGE

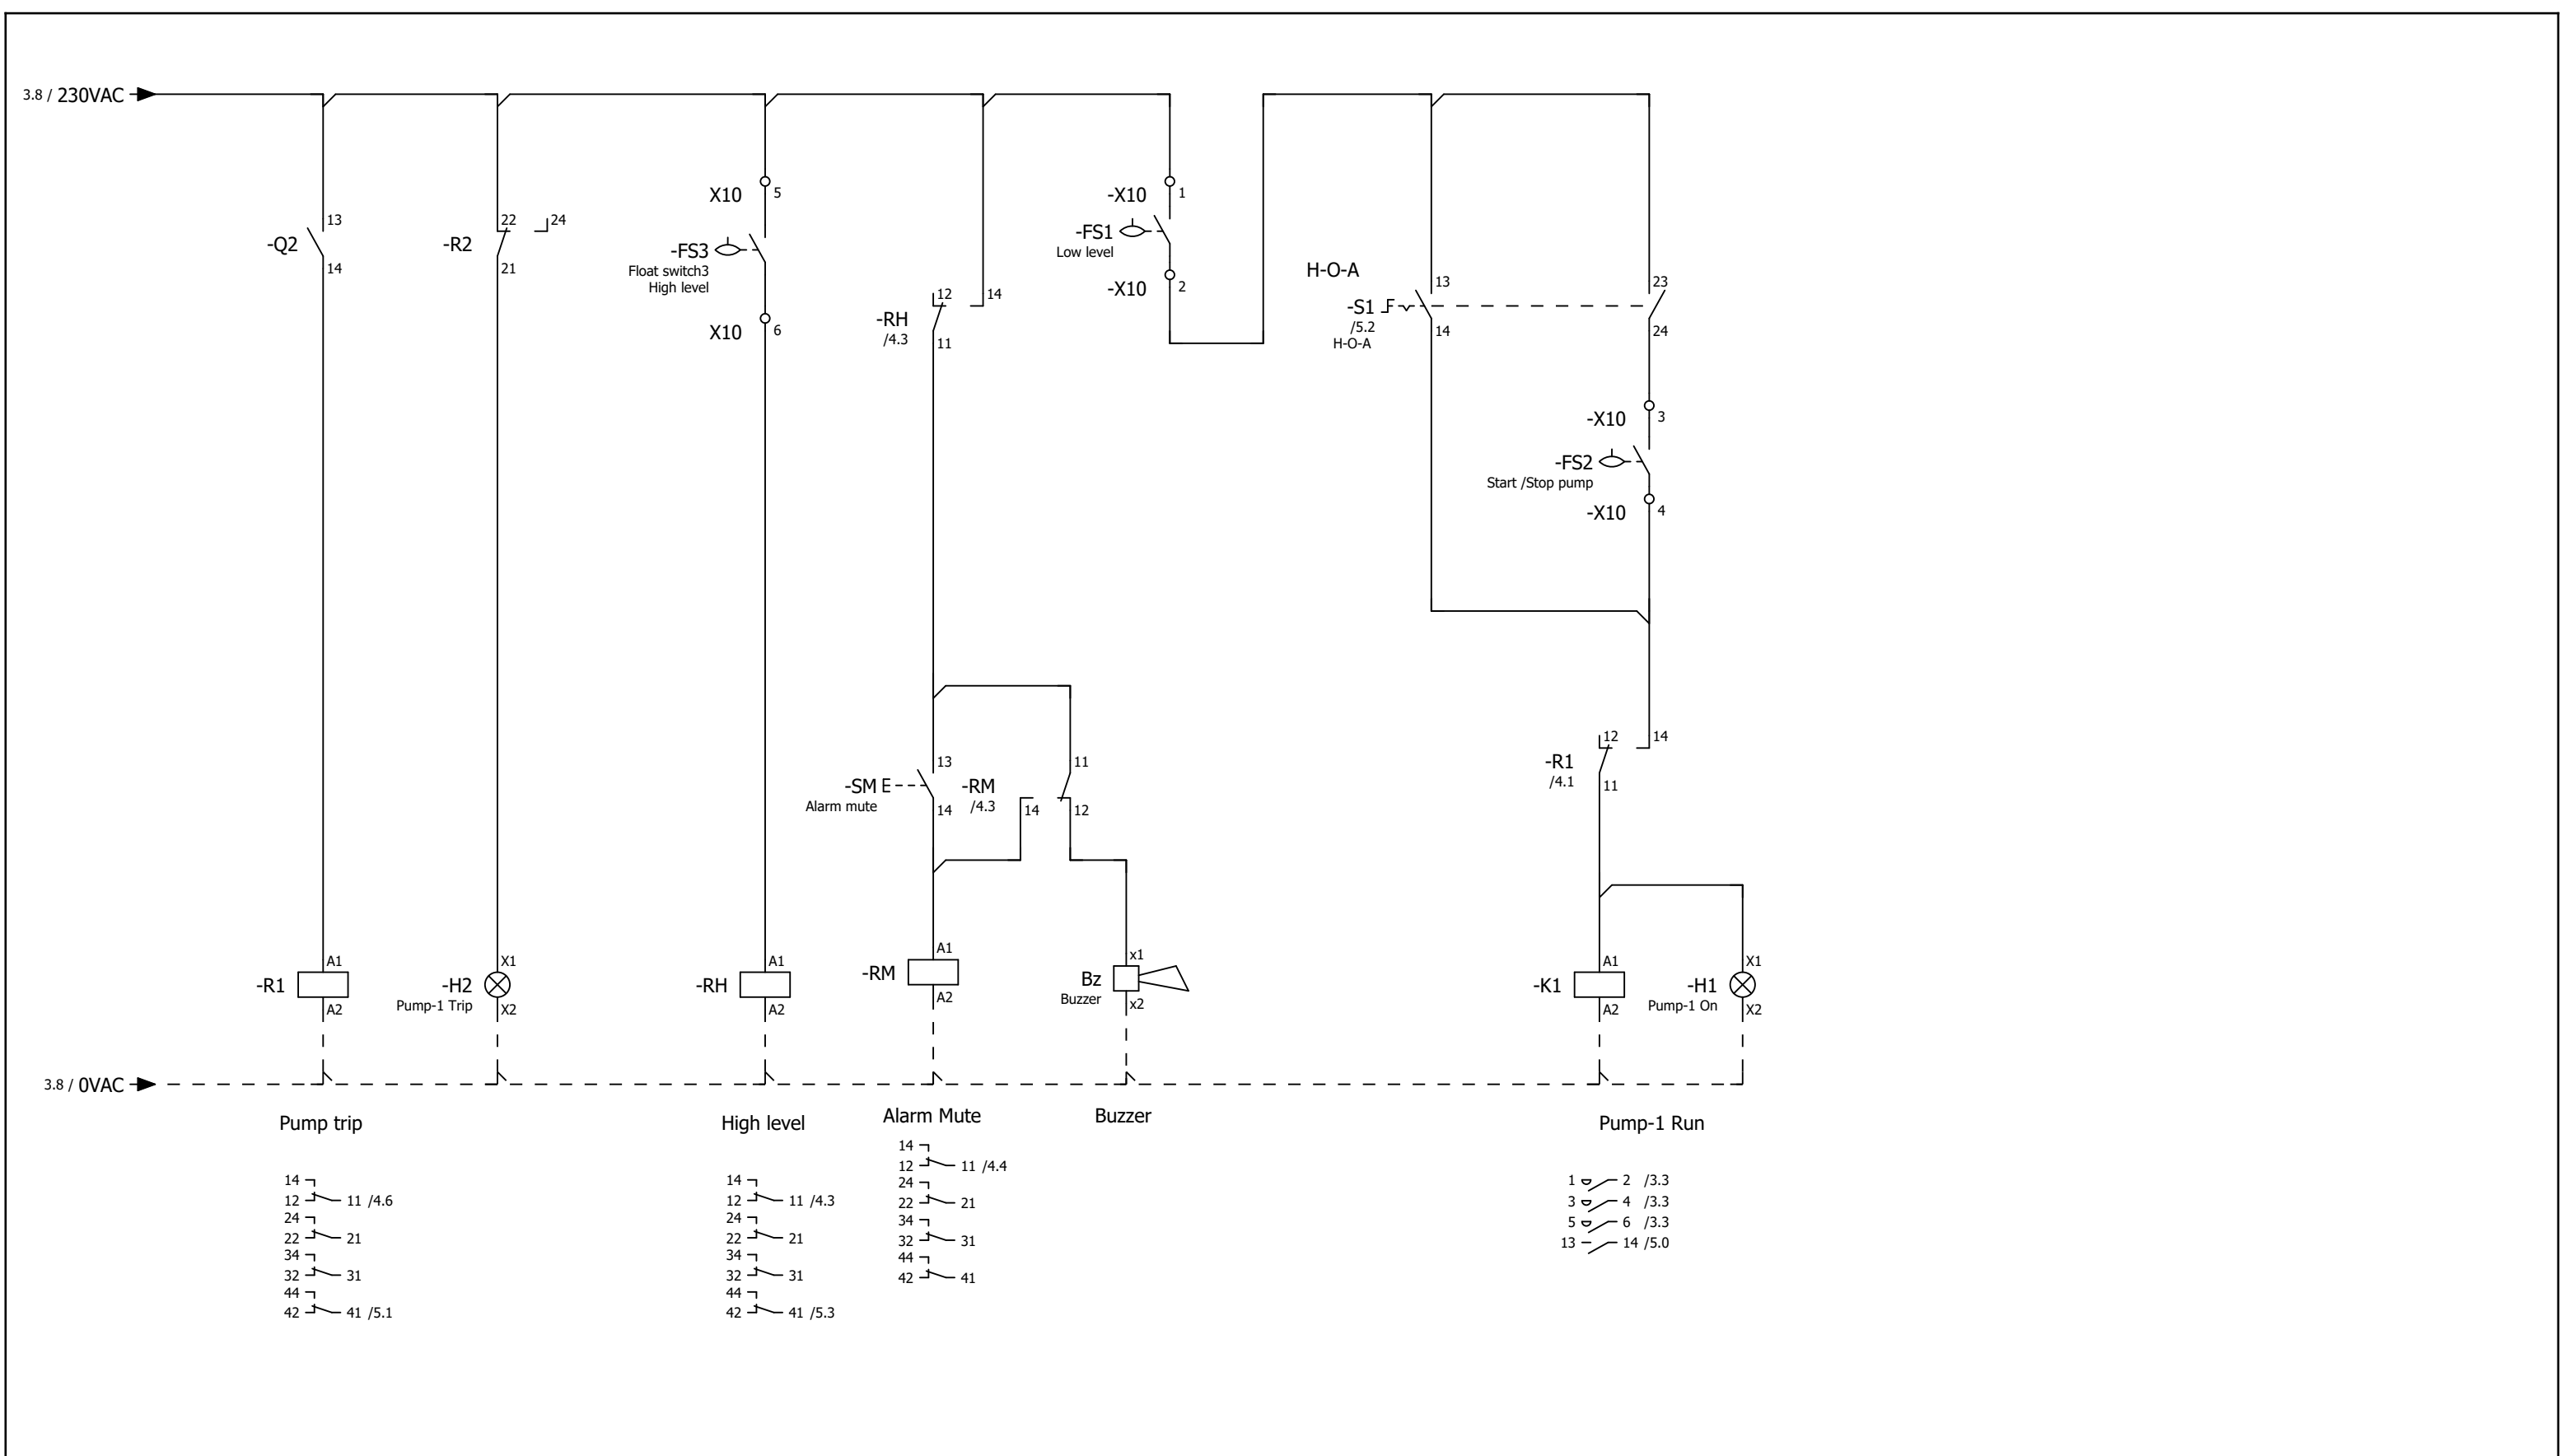

Control panel 1 x 1.5kW 3PH 400V 50Hz		Nabil	 Wilo Middle East FZE Jebel Ali Free Zone-South PO Box 262720 Dubai UAE Tel: (+971 4) 880 91 77 Fax: (+971 4) 880 91 88. Ext. 122				
		CHECKED BY					
		Siva					
TITLE	PROJECT		DRAWN			00	4 /7
		6/28/2021					
CONSULTANT	CLIENT	DATE	SCALE	DRAWING NO	REV	PAGE	

B.M.S points

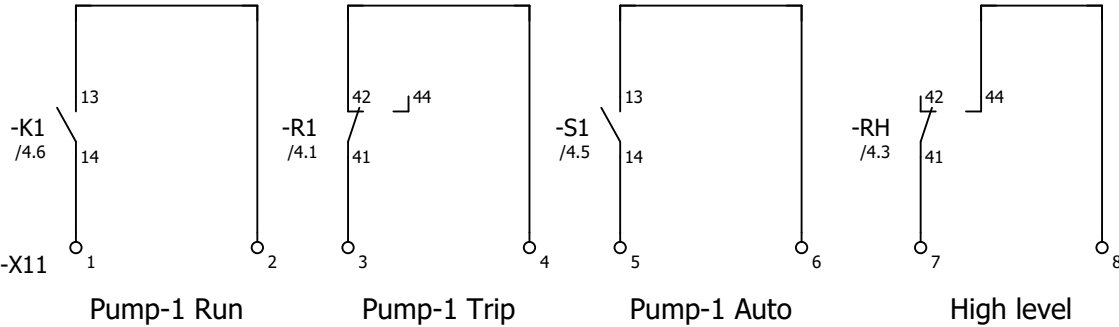


Control panel 1 x 1.5kW 3PH 400V 50Hz		Nabil	wilo Wilo Middle East FZE Jebel Ali Free Zone–South PO Box 262720 Dubai UAE Tel: (+971 4) 880 91 77 Fax: (+971 4) 880 91 88. Ext. 122			
		CHECKED BY				
		Siva				
TITLE	PROJECT					
		DRAWN			00	
		6/28/2021				
CONSULTANT	CLIENT	DATE	SCALE	DRAWING NO	REV	PAGE
						5 /7


Summarized parts list

Device Tag	Quantity	Designation	Type number	Order number	Supplier
Bz	1	Panel Mount Sounder, 30mm, 240V AC/DC, High Output, 80 dB, Black	855P-B	855P-B20SH22	Allen bradley
-F2	1	Miniature Circuit Breaker - SH201- 1P - C - 6 A	SH201-C6	2CDS211001R0064	ABB
-H1	1	Monolithic pilot light Ø 22 - Green - integral LED - 230V		HLD1122C41N3	himel
-H2	1	Monolithic pilot light Ø 22 - Red - integral LED - 230V		HLD1122C41N4	himel
-K1	1	Contactor 12A 3P 230-240V AC 1NO auxilary	AX12-30-10-88	1SBL911074R8810	ABB
-M2	1	Metal Enclosure 400H x 300W x200D IP65 RAL7035	ER	ER403020D	
-N	1	Feed-through terminal block 35sqmm	TB 35 EI	5792173	PXC
-N	1	End-cover for 35sqmm	D-TB 35 E	5793005	PXC
-N;-X10;X1;X10	7	End Bracket	E/TB	3246966	PXC
-Q0	1	OT40F3 switch-disconnector	OT40F3	1SCA104902R1001	ABB
-Q0	1	OHBS2AJ1 SELECTOR HANDLE	OHBS2AJ1	1SCA105215R1001	ABB
-Q0	1	OXS6X180 SHAFT for selector handle	OXS6X180	1SCA101659R1001	ABB
-Q1	1	MS116-4.0 Manual Motor Starter	MS116-4.0	1SAM250000R1008	ABB
-Q1	1	Aux.-contact for front mounting	HKF1-11	1SAM201901R1001	ABB
-R1;-RH;-RM	3	CR-M230AC4 Pluggable interface relay 4c/o, A1-A2=230VAC, 250V/6A	CR-M230AC4	1SVR405613R3000	ABB
-R1;-RH;-RM	3	CR-M4SS Standard socket for 2c/o or 4c/o CR-M relay	CR-M4SS	1SVR405651R3000	ABB
-S1	1	SELECTOR SWITCH 230VAC	HLAY5ED33	HLAY5ED33	Himel
-SM	1	Compact Pushbutton push-button Ø22 spring return black 1 NO+1NC		HLAY5EA25	Himel
X1	3	Feed-through terminal block	TB 4 EI	3246023	PXC
X1	3	End-cover for 4 to 10	D-TB4/10 E	3246104	PXC
-X10;-X11;X10	14	Feed-through terminal block	TB 2,5 EI	3246010	PXC


Control panel 1 x 1.5kW 3PH 400V 50Hz		Nabil	 Wilo Middle East FZE Jebel Ali Free Zone–South PO Box 262720 Dubai UAE Tel: (+971 4) 880 91 77 Fax: (+971 4) 880 91 88. Ext. 122			
		CHECKED BY				
		Siva				
TITLE	PROJECT					
		DRAWN			00	6 /7
		6/28/2021				
CONSULTANT	CLIENT	DATE	SCALE	DRAWING NO	REV	PAGE

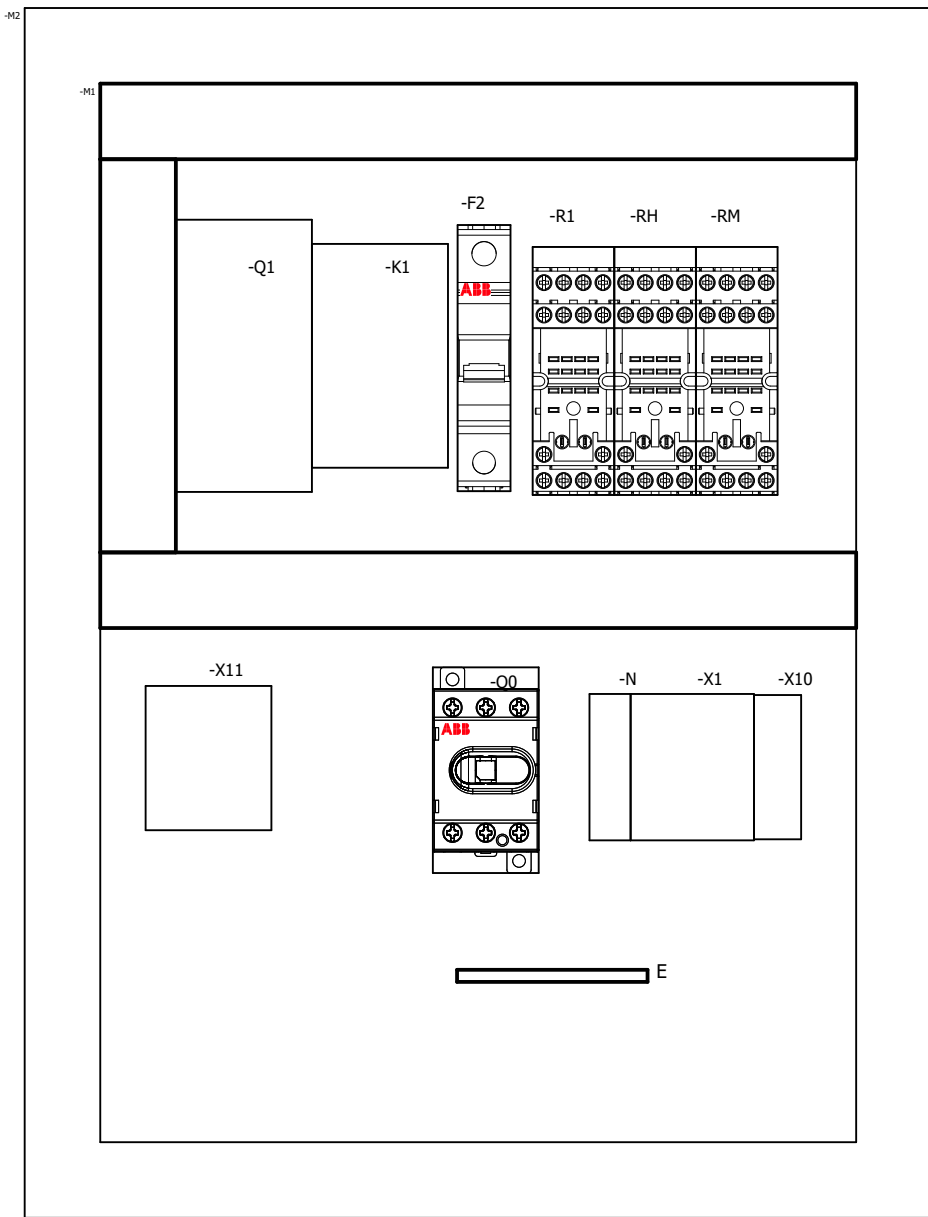

Internal View

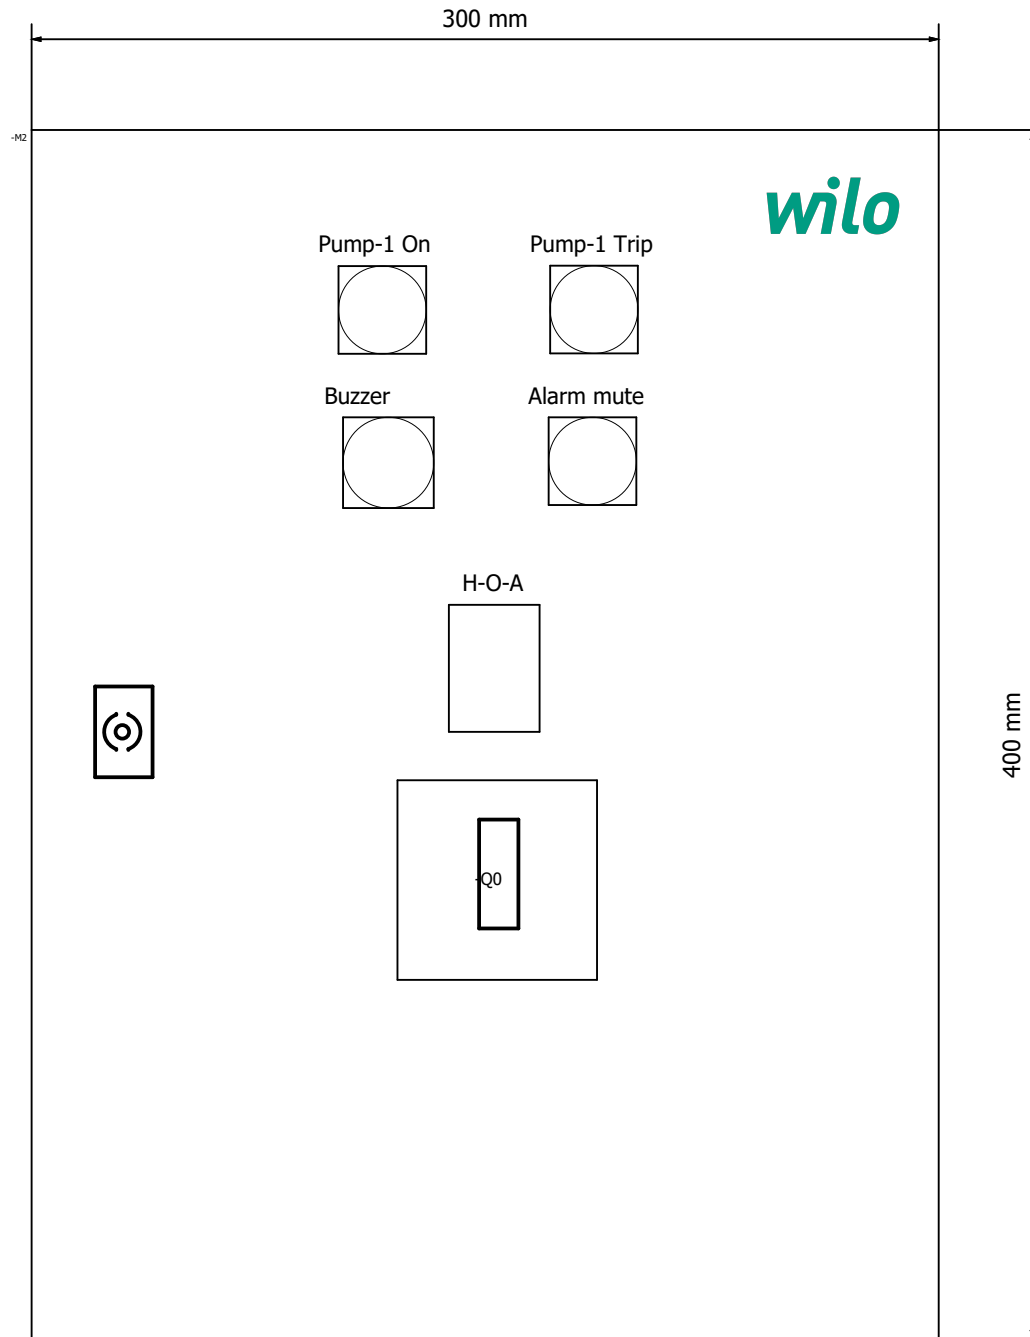

Front Fascia

 

Side view

Control panel 1 x 1.5kW 3PH 400V 50Hz		Nabil	 Wilo Middle East FZE Jebel Ali Free Zone–South PO Box 262720 Dubai UAE Tel: (+971 4) 880 91 77 Fax: (+971 4) 880 91 88. Ext. 122			
		CHECKED BY				
		Siva				
TITLE	PROJECT					
		DRAWN			00	7 /7
		6/28/2021				
CONSULTANT	CLIENT	DATE	SCALE	DRAWING NO	REV	PAGE