



Control panel 1 x 67kW/CM/AE

Number of Pumps	:	1
Rated Power	:	67kW
Rated Current	:	129.3A
Supply rating	:	3 x400V 50Hz
Duty/Assist/Standby	:	1Duty
Starting Method	:	Star delta
IP rating	:	IP54
Ambient Temp.	:	40 deg C
Article Number	:	6803573

Additional Specification:


PTC relay
Electrode relay

Control panel 1 x 67kW SD 3 x 400V 50Hz		A.N	 Wilo Middle East FZE Jebel Ali Free Zone–South PO Box 262720 Dubai UAE Tel: (+971 4) 880 91 77 Fax: (+971 4) 880 91 88. Ext. 122			
		CHECKED BY				
TITLE	PROJECT					
		DRAWN		Asbuilt	000	1 /8
CONSULTANT	CLIENT	DATE	SCALE	DRAWING NO	REV	PAGE


TECHNICAL DATA SHEET


[illegible]

Control panel 1 x 67kW SD 3 x 400V 50Hz		A.N	 Wilo Middle East FZE Jebel Ali Free Zone–South PO Box 262720 Dubai UAE Tel: (+971 4) 880 91 77 Fax: (+971 4) 880 91 88. Ext. 122			
		CHECKED BY				
TITLE	PROJECT					
		DRAWN		Asbuilt	000	2 /8
CONSULTANT	CLIENT	DATE	SCALE	DRAWING NO	REV	PAGE

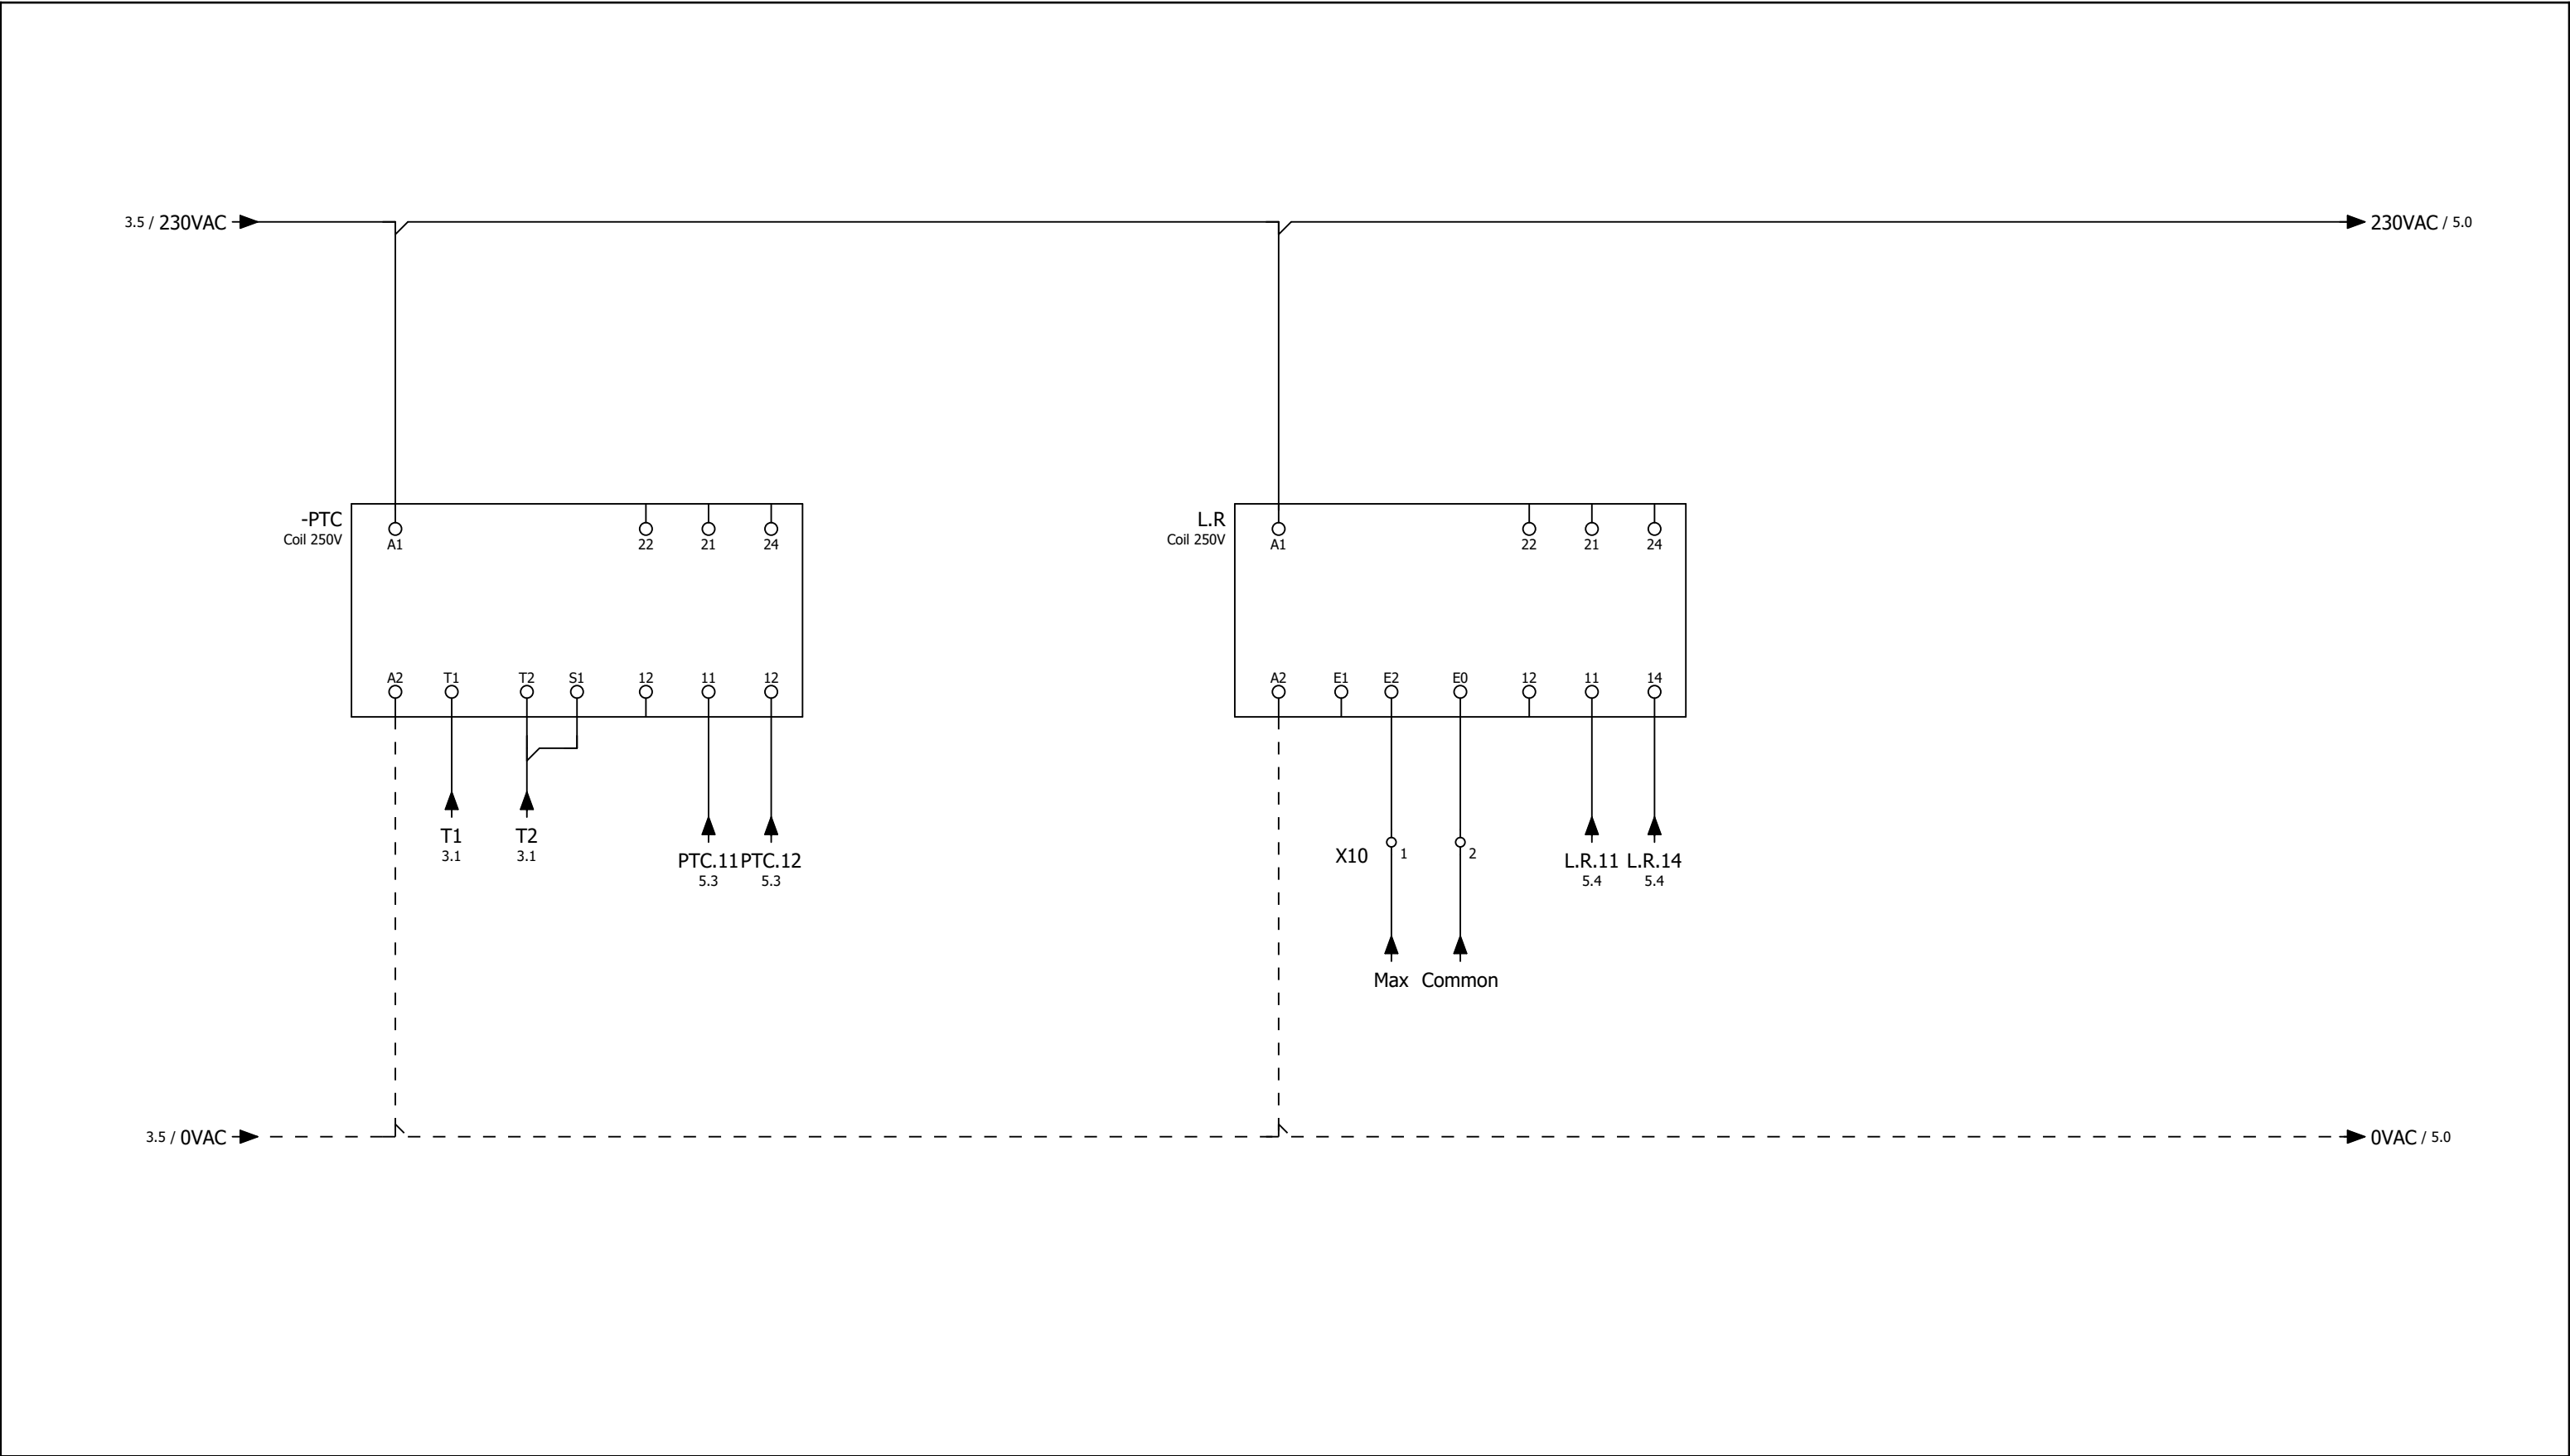


Control panel 1 x 67kW SD 3 x 400V 50Hz		A.N	wilo Wilo Middle East FZE Jebel Ali Free Zone–South PO Box 262720 Dubai UAE Tel: (+971 4) 880 91 77 Fax: (+971 4) 880 91 88. Ext. 122			
TITLE	PROJECT	DRAWN	Asbuilt		000	4 /8
CONSULTANT	CLIENT	DATE	SCALE	DRAWING NO	REV	PAGE

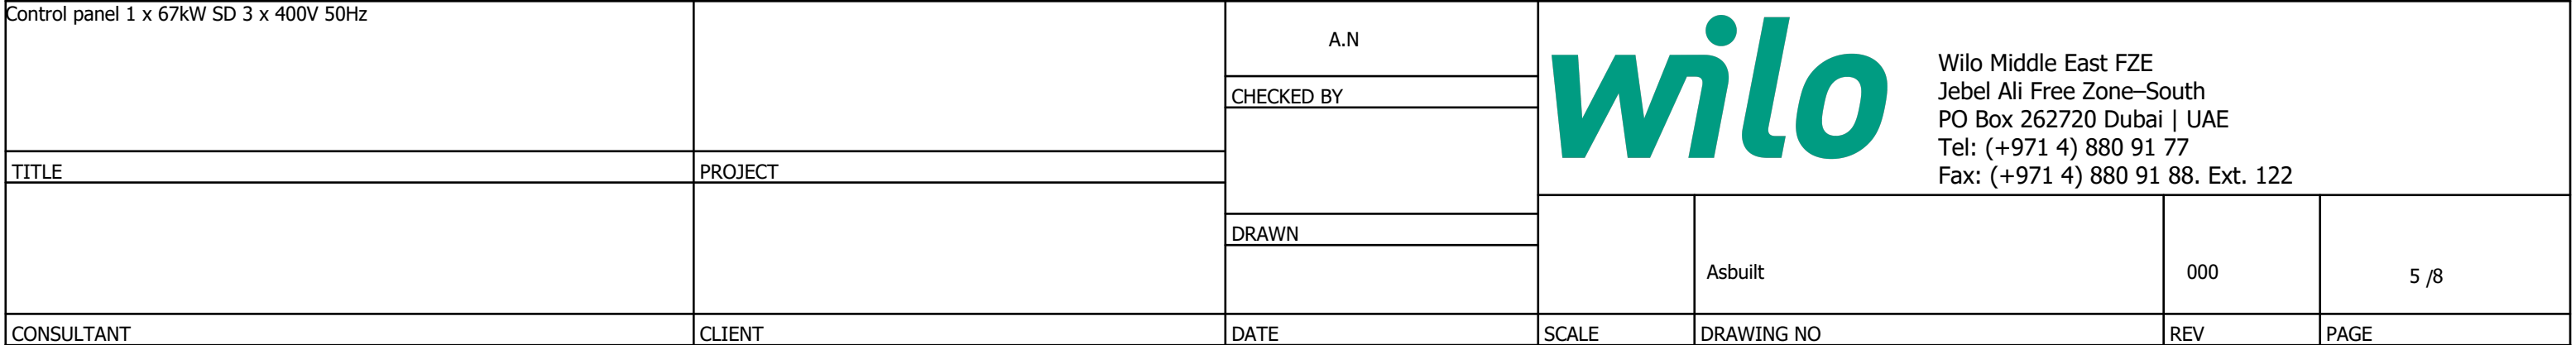


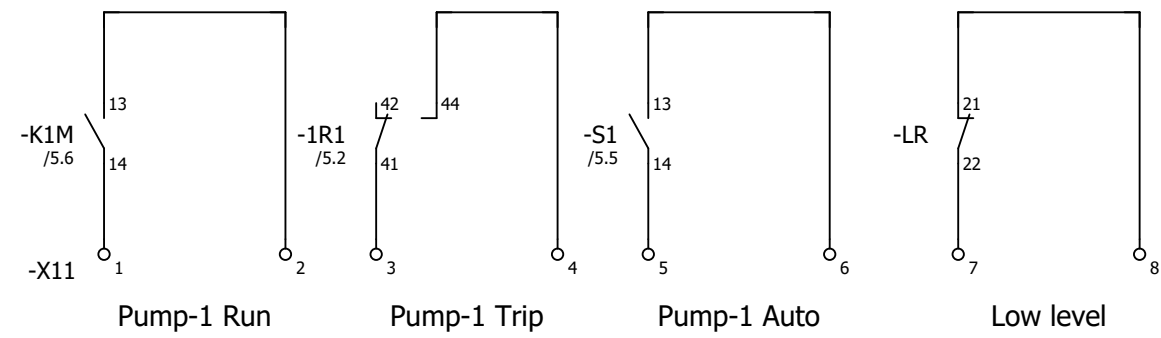


Control panel 1 x 67kW SD 3 x 400V 50Hz		A.N	wilo Wilo Middle East FZE Jebel Ali Free Zone–South PO Box 262720 Dubai UAE Tel: (+971 4) 880 91 77 Fax: (+971 4) 880 91 88. Ext. 122			
		CHECKED BY				
TITLE	PROJECT					
		DRAWN		Asbuilt	000	6 /8
CONSULTANT	CLIENT	DATE	SCALE	DRAWING NO	REV	PAGE

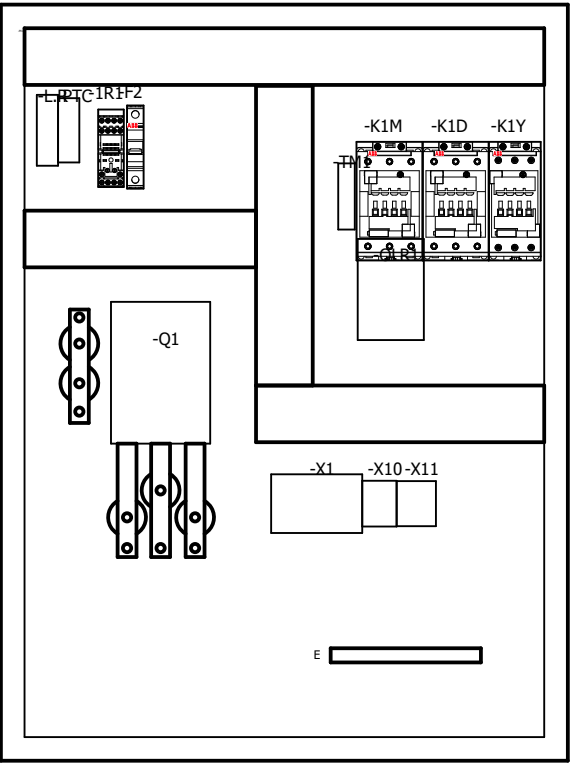

Internal View

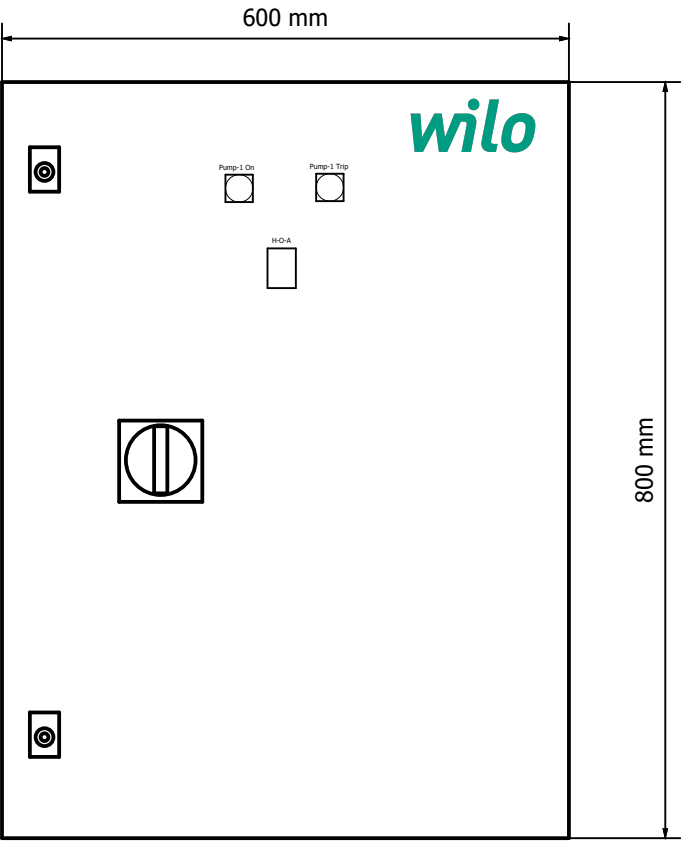

Front fascia

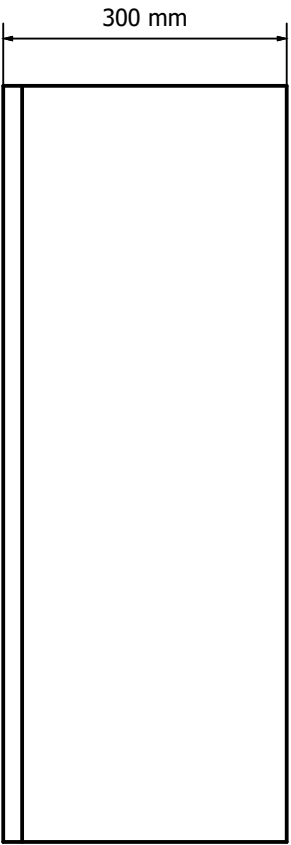

Side View

Control panel 1 x 67kW SD 3 x 400V 50Hz		A.N	wilo Wilo Middle East FZE Jebel Ali Free Zone–South PO Box 262720 Dubai UAE Tel: (+971 4) 880 91 77 Fax: (+971 4) 880 91 88. Ext. 122			
		CHECKED BY				
TITLE	PROJECT					
		DRAWN		Asbuilt	000	7 /8
CONSULTANT	CLIENT	DATE	SCALE	DRAWING NO	REV	PAGE

Summarized parts list

Device Tag	Quantity	Designation	Type number	Order number	Supplier
-F2	1	Miniature Circuit Breaker - SH201- 1P - C - 6 A	SH201-C6	2CDS211001R0064	ABB
-H1	1	Monolithic pilot light Ø 22 - Green - integral LED - 230V		HLD1122C41N3	himel
-H2	1	Monolithic pilot light Ø 22 - Red - integral LED - 230V		HLD1122C41N4	himel
-K1D;-K1M	2	AF80-30-00-13 100-250V50/60HZ-DC Contactor	AF80-30-00-13	1SBL397001R1300	ABB
-K1D;-K1Y	2	CA4-10 Auxiliary Contact Block 1NO	CA4-10	1SBN010110R1010	
-K1D;-K1Y	2	CA4-01 Auxiliary Contact Block 1NC	CA4-01	1SBN010110R1001	
-K1Y	1	AF52-30-00-13 100-250V50/60HZ-DC Contactor	AF52-30-00-13	1SBL367001R1300	ABB
L.R	1	Electrode relay 230V AC	NIV105/S	NIV105/S	Wilo
-M1	1	Metal Enclosure 800H x 600W x300D RAL7035	ER	ER806030D	
-OLR1	1	Thermal Overload Relay 75... 87A	1SAZ911201R1005	1SAZ911201R1005	ABB
-PTC	1	Thermistor motor protection relay	CM-MSS.13S	CM-MSS.13S	ABB
-Q1	1	XT3N 250 TMD 160-1600 3p F F 50°C	XT3N 250 TMD 160-1600 3p F F 50°C	1SDA070161R1	ABB
-Q1	1	RHE XT1-XT3 F/P STAND. RETURNED	XT1 Tmax	1SDA066479R1	ABB
-1R1	1	CR-M4SS Standard socket for 2c/o or 4c/o CR-M relay	CR-M4SS	1SVR405651R3000	ABB
-1R1	1	CR-M230AC4 Pluggable interface relay 4c/o, A1-A2=230VAC, 250V/6A	CR-M230AC4	1SVR405613R3000	ABB
-S1	1	SELECTOR SWITCH 230VAC	HLAY5ED33	HLAY5ED33	Himel
-S1	1	CONTACT BLOCK BE101 NO contact	HLAY5BE101	HLAY5BE101	Himel
-TM1	1	Electronic timer On delay 0.05 s to 100 h s,screw-clamps terminals 24 - 230VAC	CT-ERD	1SVR500100R0000	ABB
-X1;-X10	2	End Bracket	E/TB	3246966	PXC
-X1;X1	6	Feed-through terminal block 35sqmm	TB 35 EI	5792173	PXC
-X1;-X10;-X11;X10	14	Feed-through terminal block	TB 2,5 EI	3246010	PXC
X10	2	End-cover for 4 to 10	D-TB4/10 E	3246104	PXC

Control panel 1 x 67kW SD 3 x 400V 50Hz		A.N	 Wilo Middle East FZE Jebel Ali Free Zone–South PO Box 262720 Dubai UAE Tel: (+971 4) 880 91 77 Fax: (+971 4) 880 91 88. Ext. 122			
		CHECKED BY				
TITLE	PROJECT					
		DRAWN		Asbuilt	000	8 /8
CONSULTANT	CLIENT	DATE	SCALE	DRAWING NO	REV	PAGE